

- 1 THIS DRAWING IS COPYRIGHT.
- 2 THIS DRAWING MUST NOT BE SCALED
- 3 CONTRACTOR TO CHECK ALL DIMENSIONS ON SITE.

### LEGEND


DIM*	CA TO AGREED DIMENSION ON SITE
EQ	EQUAL DIMENSION
F.F.L. 100.00 C.H. 2.40	FINISHED FLOOR LEVEL CEILING HEIGHT
D.0.00.A W.0.00.A	DOOR ROOM NUMBER REFERENCE WINDOW ROOM NUMBER REFERENCE
0.00	ROOM NUMBER
ROOM	ROOM NAME
00.01m <sup>2</sup>	ROOM AREA
	EXISTING CONSTRUCTION
	BUILDING AS CONSTRUCTED TO BE RETAINED
	BUILDING FOOTPRINT APPROVED UNDER PL NO.20117

#### AREA SCHEDULE, AS BUILT.

FLOOR LEVEL	GROSS AREA
0 GROUND	1166m <sup>2</sup>
1 FIRST	172m <sup>2</sup>
TOTAL	1338m <sup>2</sup>



**PLANNING DOCUMENTS**  
DATE: 20.04.21

20.04.21 LW ISSUED FOR PLANNING  
No. | Date | JNL | Revision



7 Clena Terrace, Spawell  
Road, Wenford, YS5 9Y9K | Tel: 053 9174144 | info@conroyarchitects.ie  
www.conroyarchitects.ie

Job: SARSTEDT, SINNOTTSTOWN LANE.		
Drawing: GROUND FLOOR PLAN - As Existing		
Drawn: Lucy Whelan	Status: Planning	
Scale: 1:200/A3	Date: 31.03.21	Checked: N. Conroy
Job No: 20.003	Drawing No: P.03	Revision: -

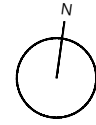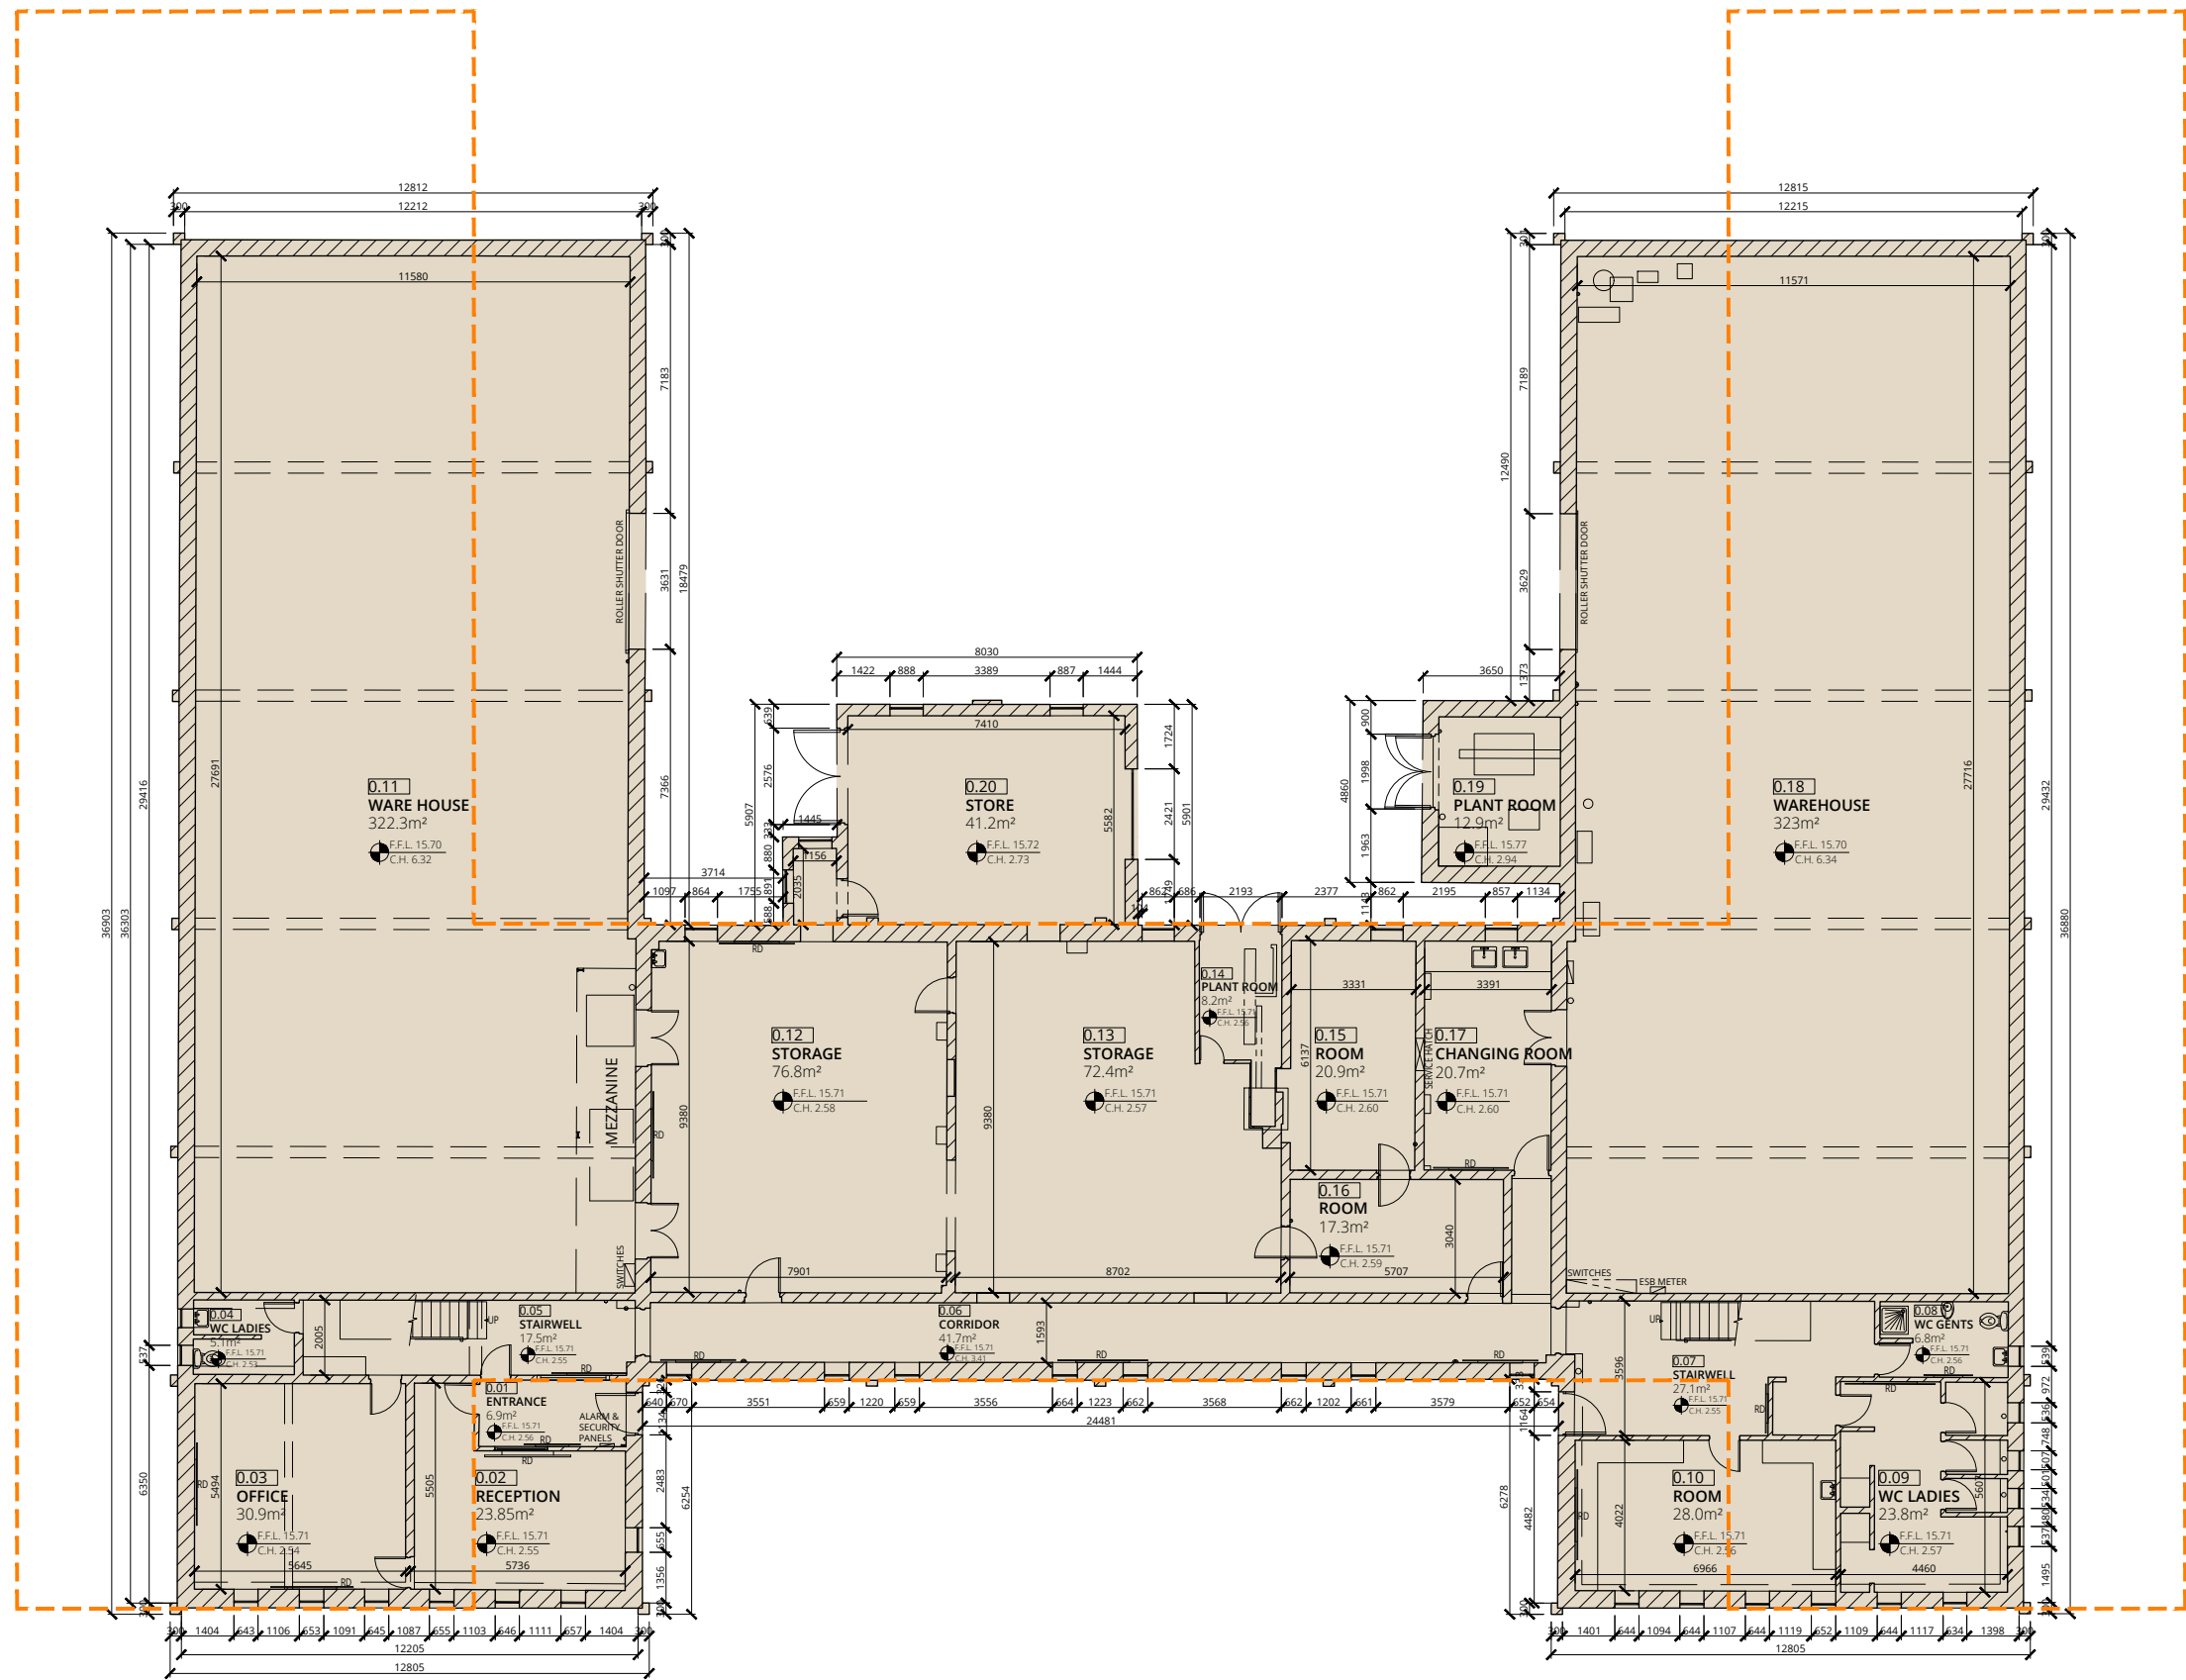

**1** GROUND FLOOR PLAN- As Existing  
Scale 1:200/A3