

1 THIS DRAWING IS COPYRIGHT.
 2 THIS DRAWING MUST NOT BE SCALED
 3 CONTRACTOR TO CHECK ALL DIMENSIONS ON SITE.

LEGEND

1/00 DETAIL NUMBER
 DRAWING REFERENCE


DIM* EQ CA TO AGREED DIMENSION ON SITE
 EQUAL DIMENSION

F.F.L. 100.00 FINISHED FLOOR LEVEL
 C.H. 2.40 CEILING HEIGHT

F.R.L. 100.00 FLAT ROOF LEVEL

0.00 ROOM NUMBER
 ROOM NAME
 00.01m² ROOM AREA

EXISTING CONSTRUCTION
 BUILDING AS CONSTRUCTED TO BE RETAINED
 BUILDING FOOTPRINT APPROVED UNDER PL NO.20117

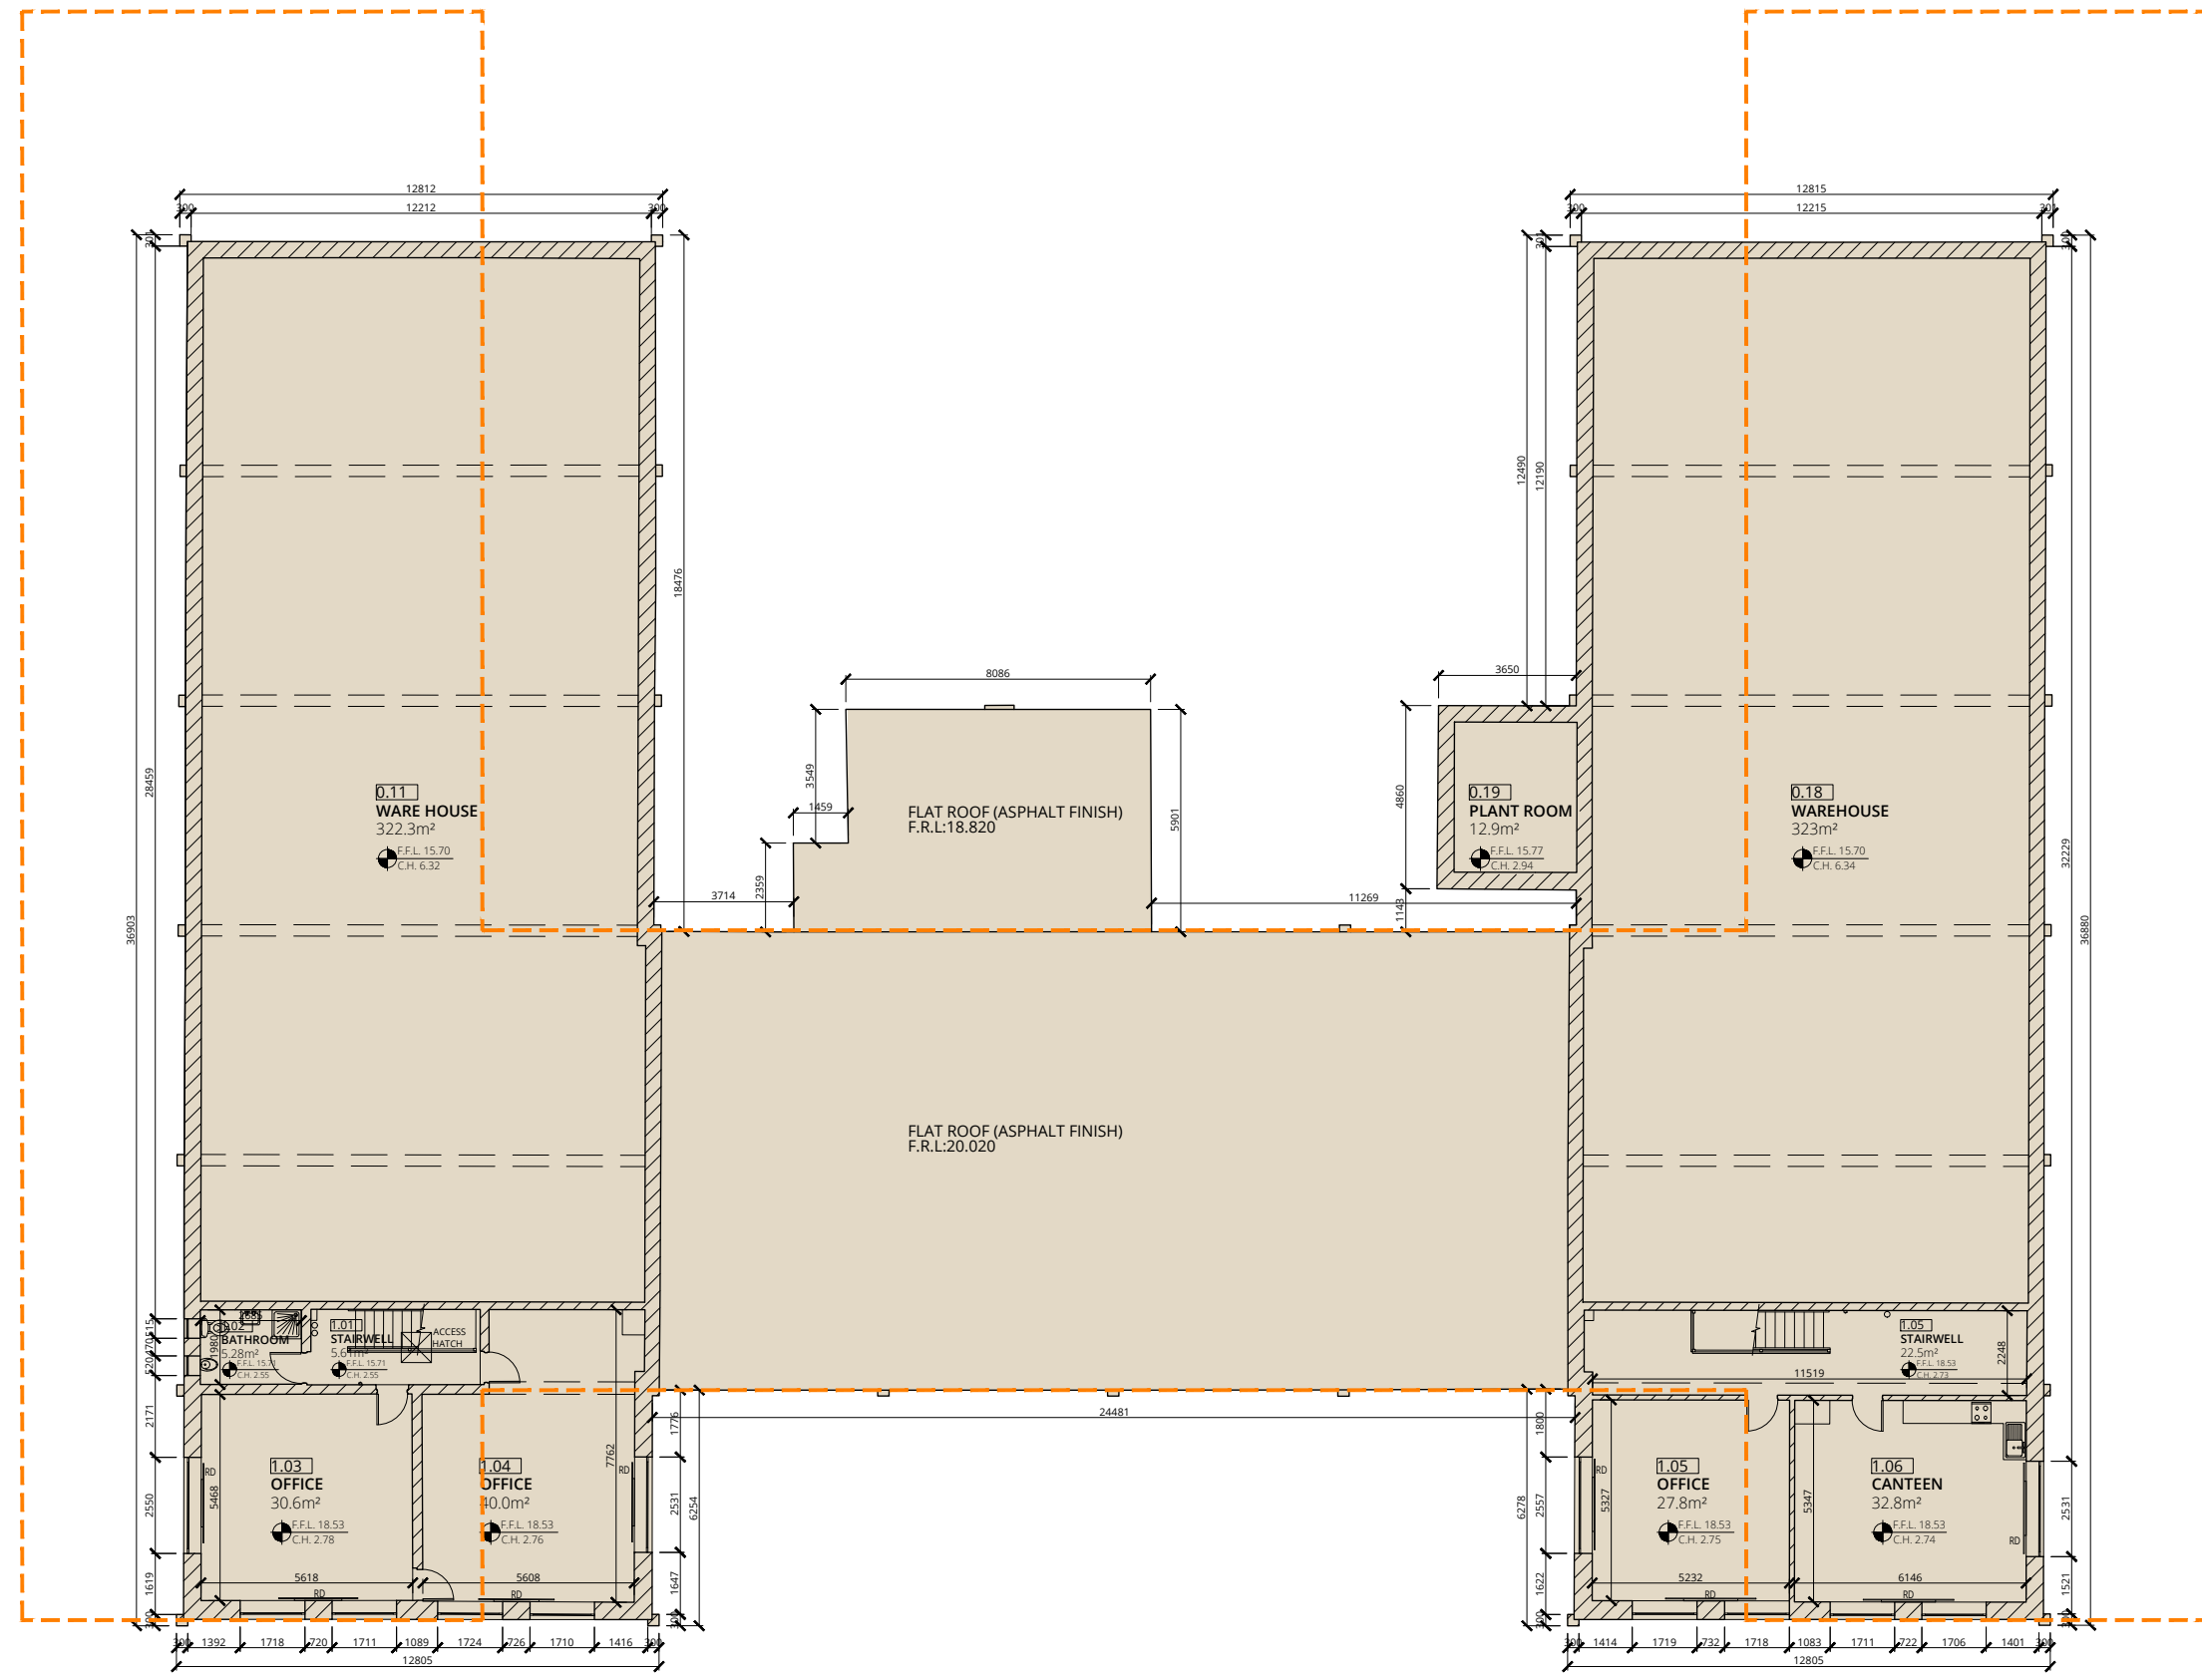

AREA SCHEDULE, AS BUILT.

FLOOR LEVEL	GROSS AREA
0 GROUND	1166m ²
1 FIRST	172m ²
TOTAL	1338m²

PLANNING DOCUMENTS
 DATE: 20.04.21

20.04.21 LW ISSUED FOR PLANNING
 No. Date JNL Revision


CONROY ARCHITECTS

7 Glens Terrace, Spawell
 Road, Wexford, Y55 Y79K | Tel: 053 9174144 | info@conroyarchitects.ie
 www.conroyarchitects.ie

Job: SARSTEDT, SINNOTTSTOWN LANE.

Drawing: FIRST FLOOR PLAN - As Existing

Drawn: Lucy Whelan Status: Planning
 Scale: 1:200/A3 Date: 31.03.21 Checked: N. Conroy
 Job No: 20.003 Drawing No: P.04 Revision: -

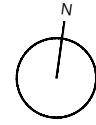

1 FIRST FLOOR PLAN- As Existing
 Scale 1:200/A3